


AS-BUILT PLAN

LOCATED AT
17 ESSEX STREET
LYNNFIELD, MA

SCALE: 1 INCH = 40 FEET

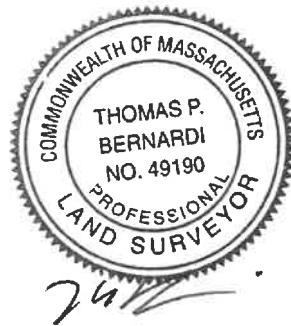

REFERENCES



DEED: BOOK 36336, PAGE 513
 PLAN: BOOK 78, PLAN 34

CERTIFICATION

I CERTIFY THAT THIS PLAN WAS MADE FROM AN INSTRUMENT SURVEY ON THE GROUND IN AUGUST OF 2018 AND JUNE OF 2021 AND ALL STRUCTURES ARE LOCATED AS SHOWN HEREON.

I HEREBY CERTIFY THAT THIS PLAN WAS PREPARED IN CONFORMITY WITH THE RULES AND REGULATIONS OF THE REGISTERS OF DEEDS OF THE COMMONWEALTH OF MASSACHUSETTS.

THOMAS BERNARDI P.L.S.
 DATE: 3-11-2022

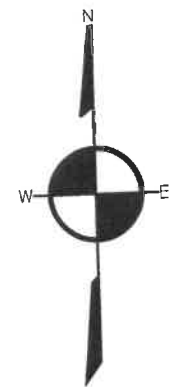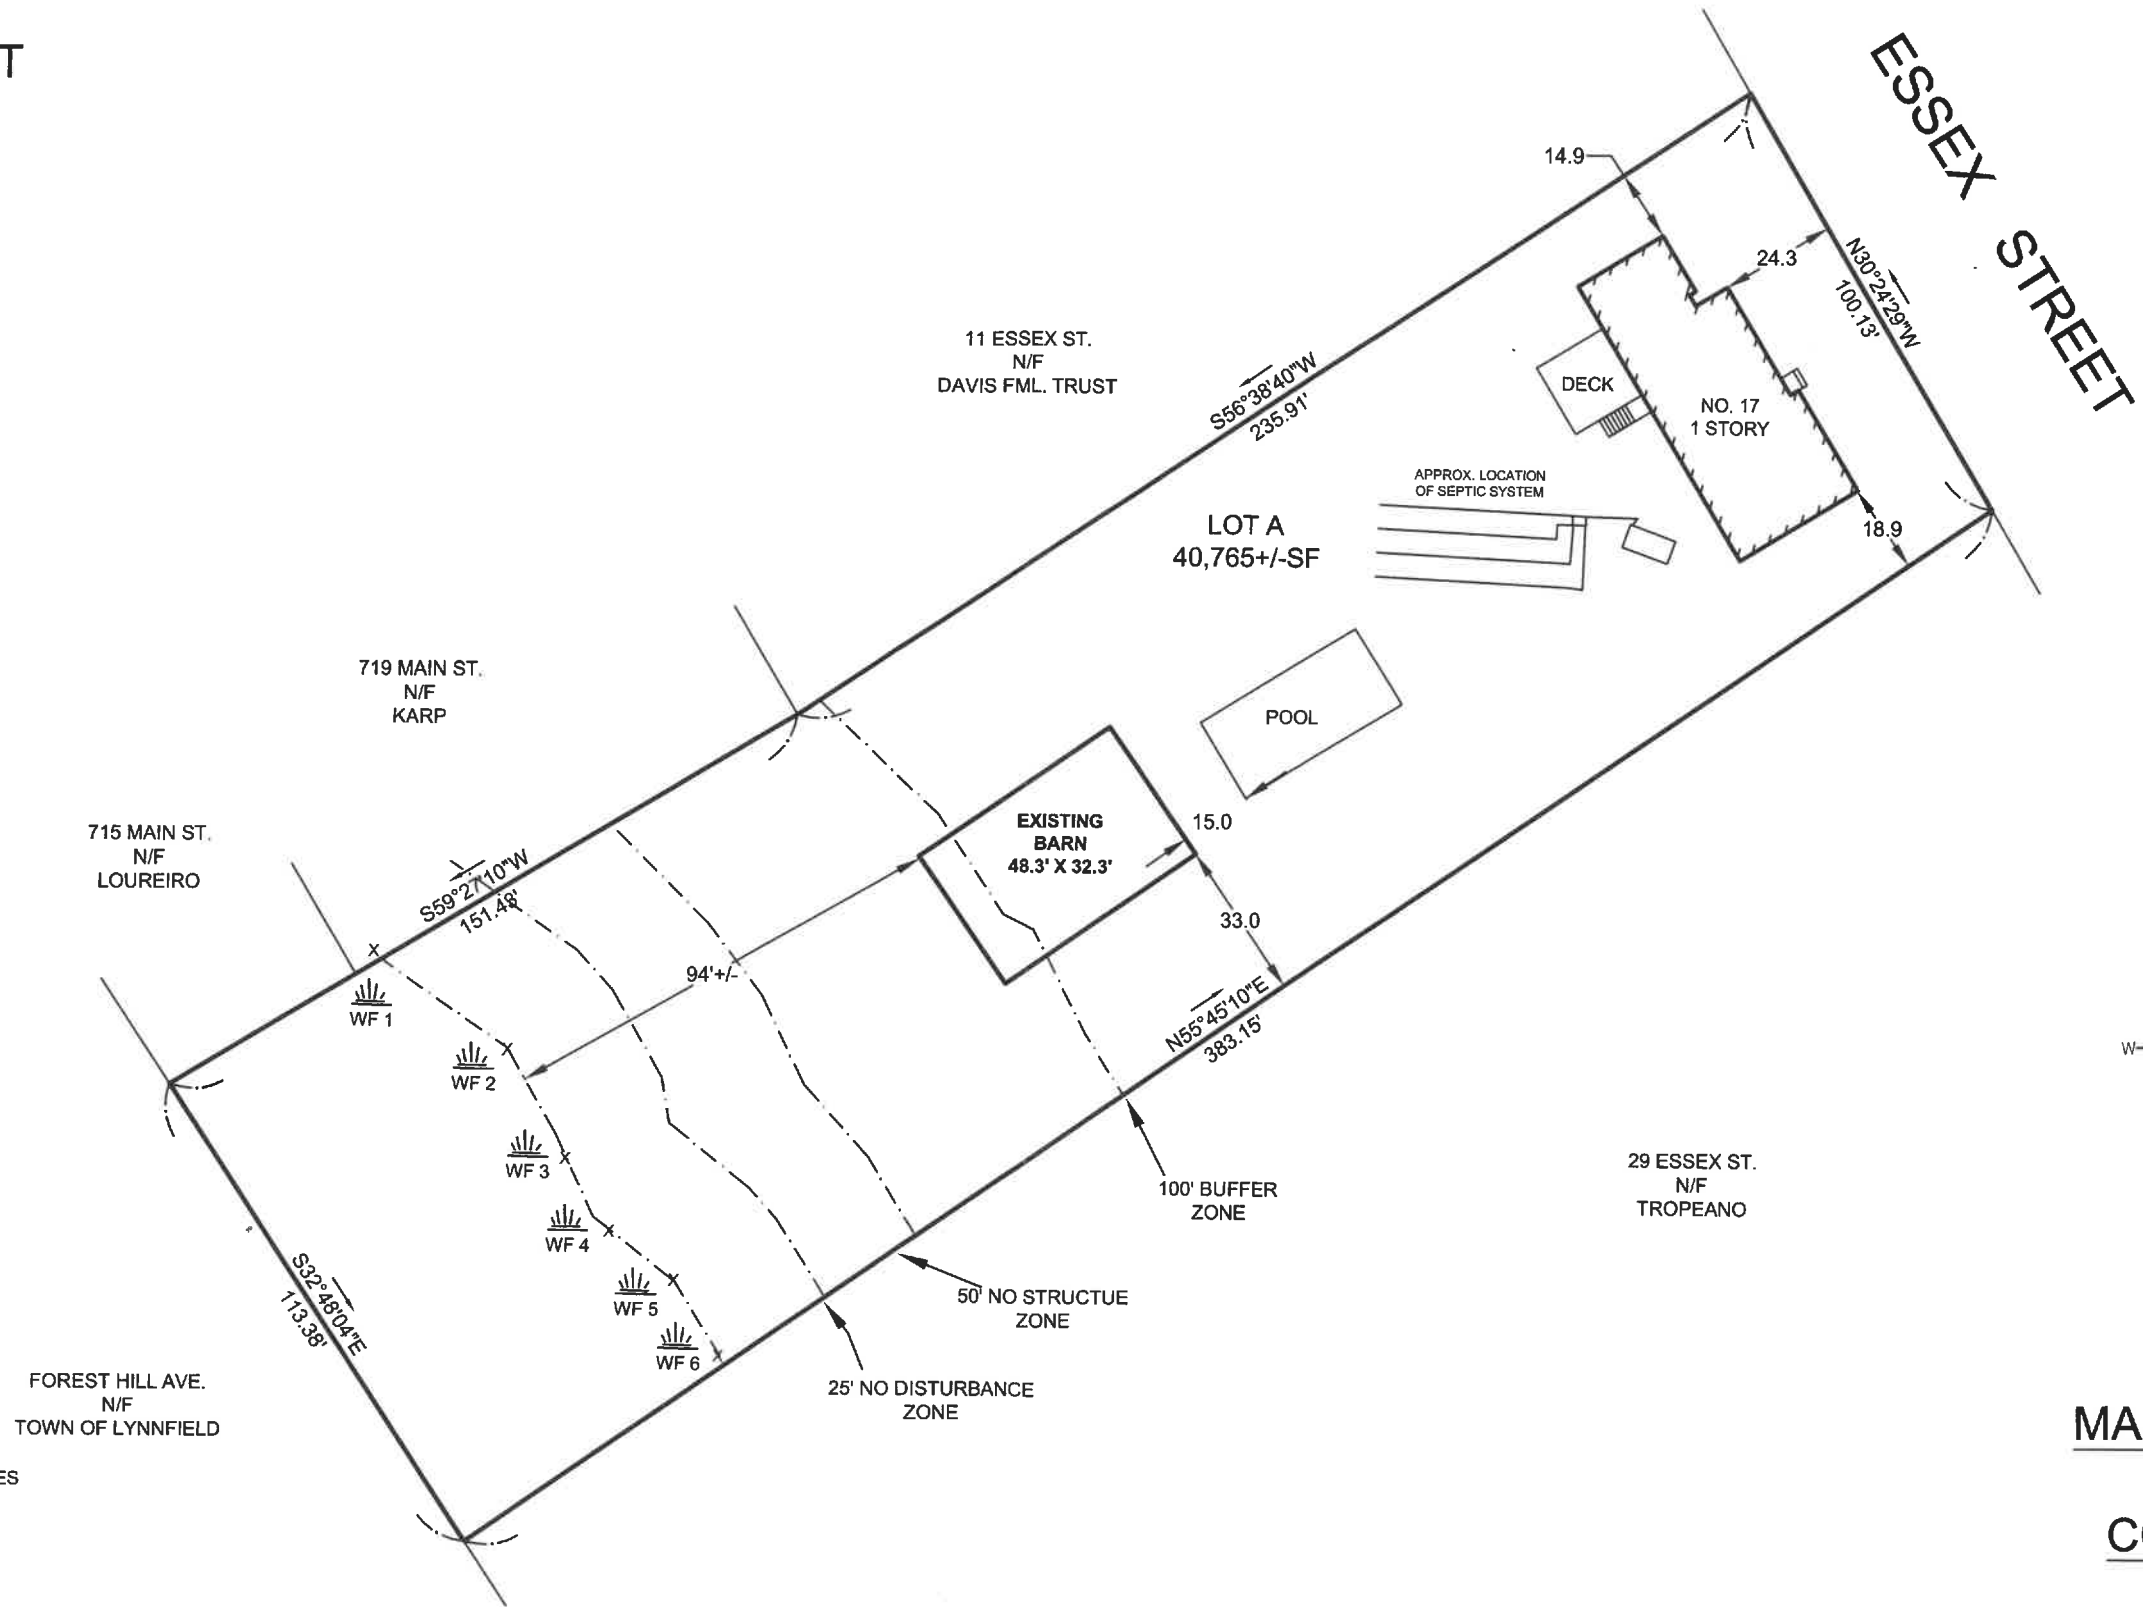

MASSACHUSETTS
SURVEY
CONSULTANTS

14 SUMNER STREET
 GLOUCESTER, MA 01930
 617 899-0703
 WWW.MASSACHUSETTSSURVEY.COM