

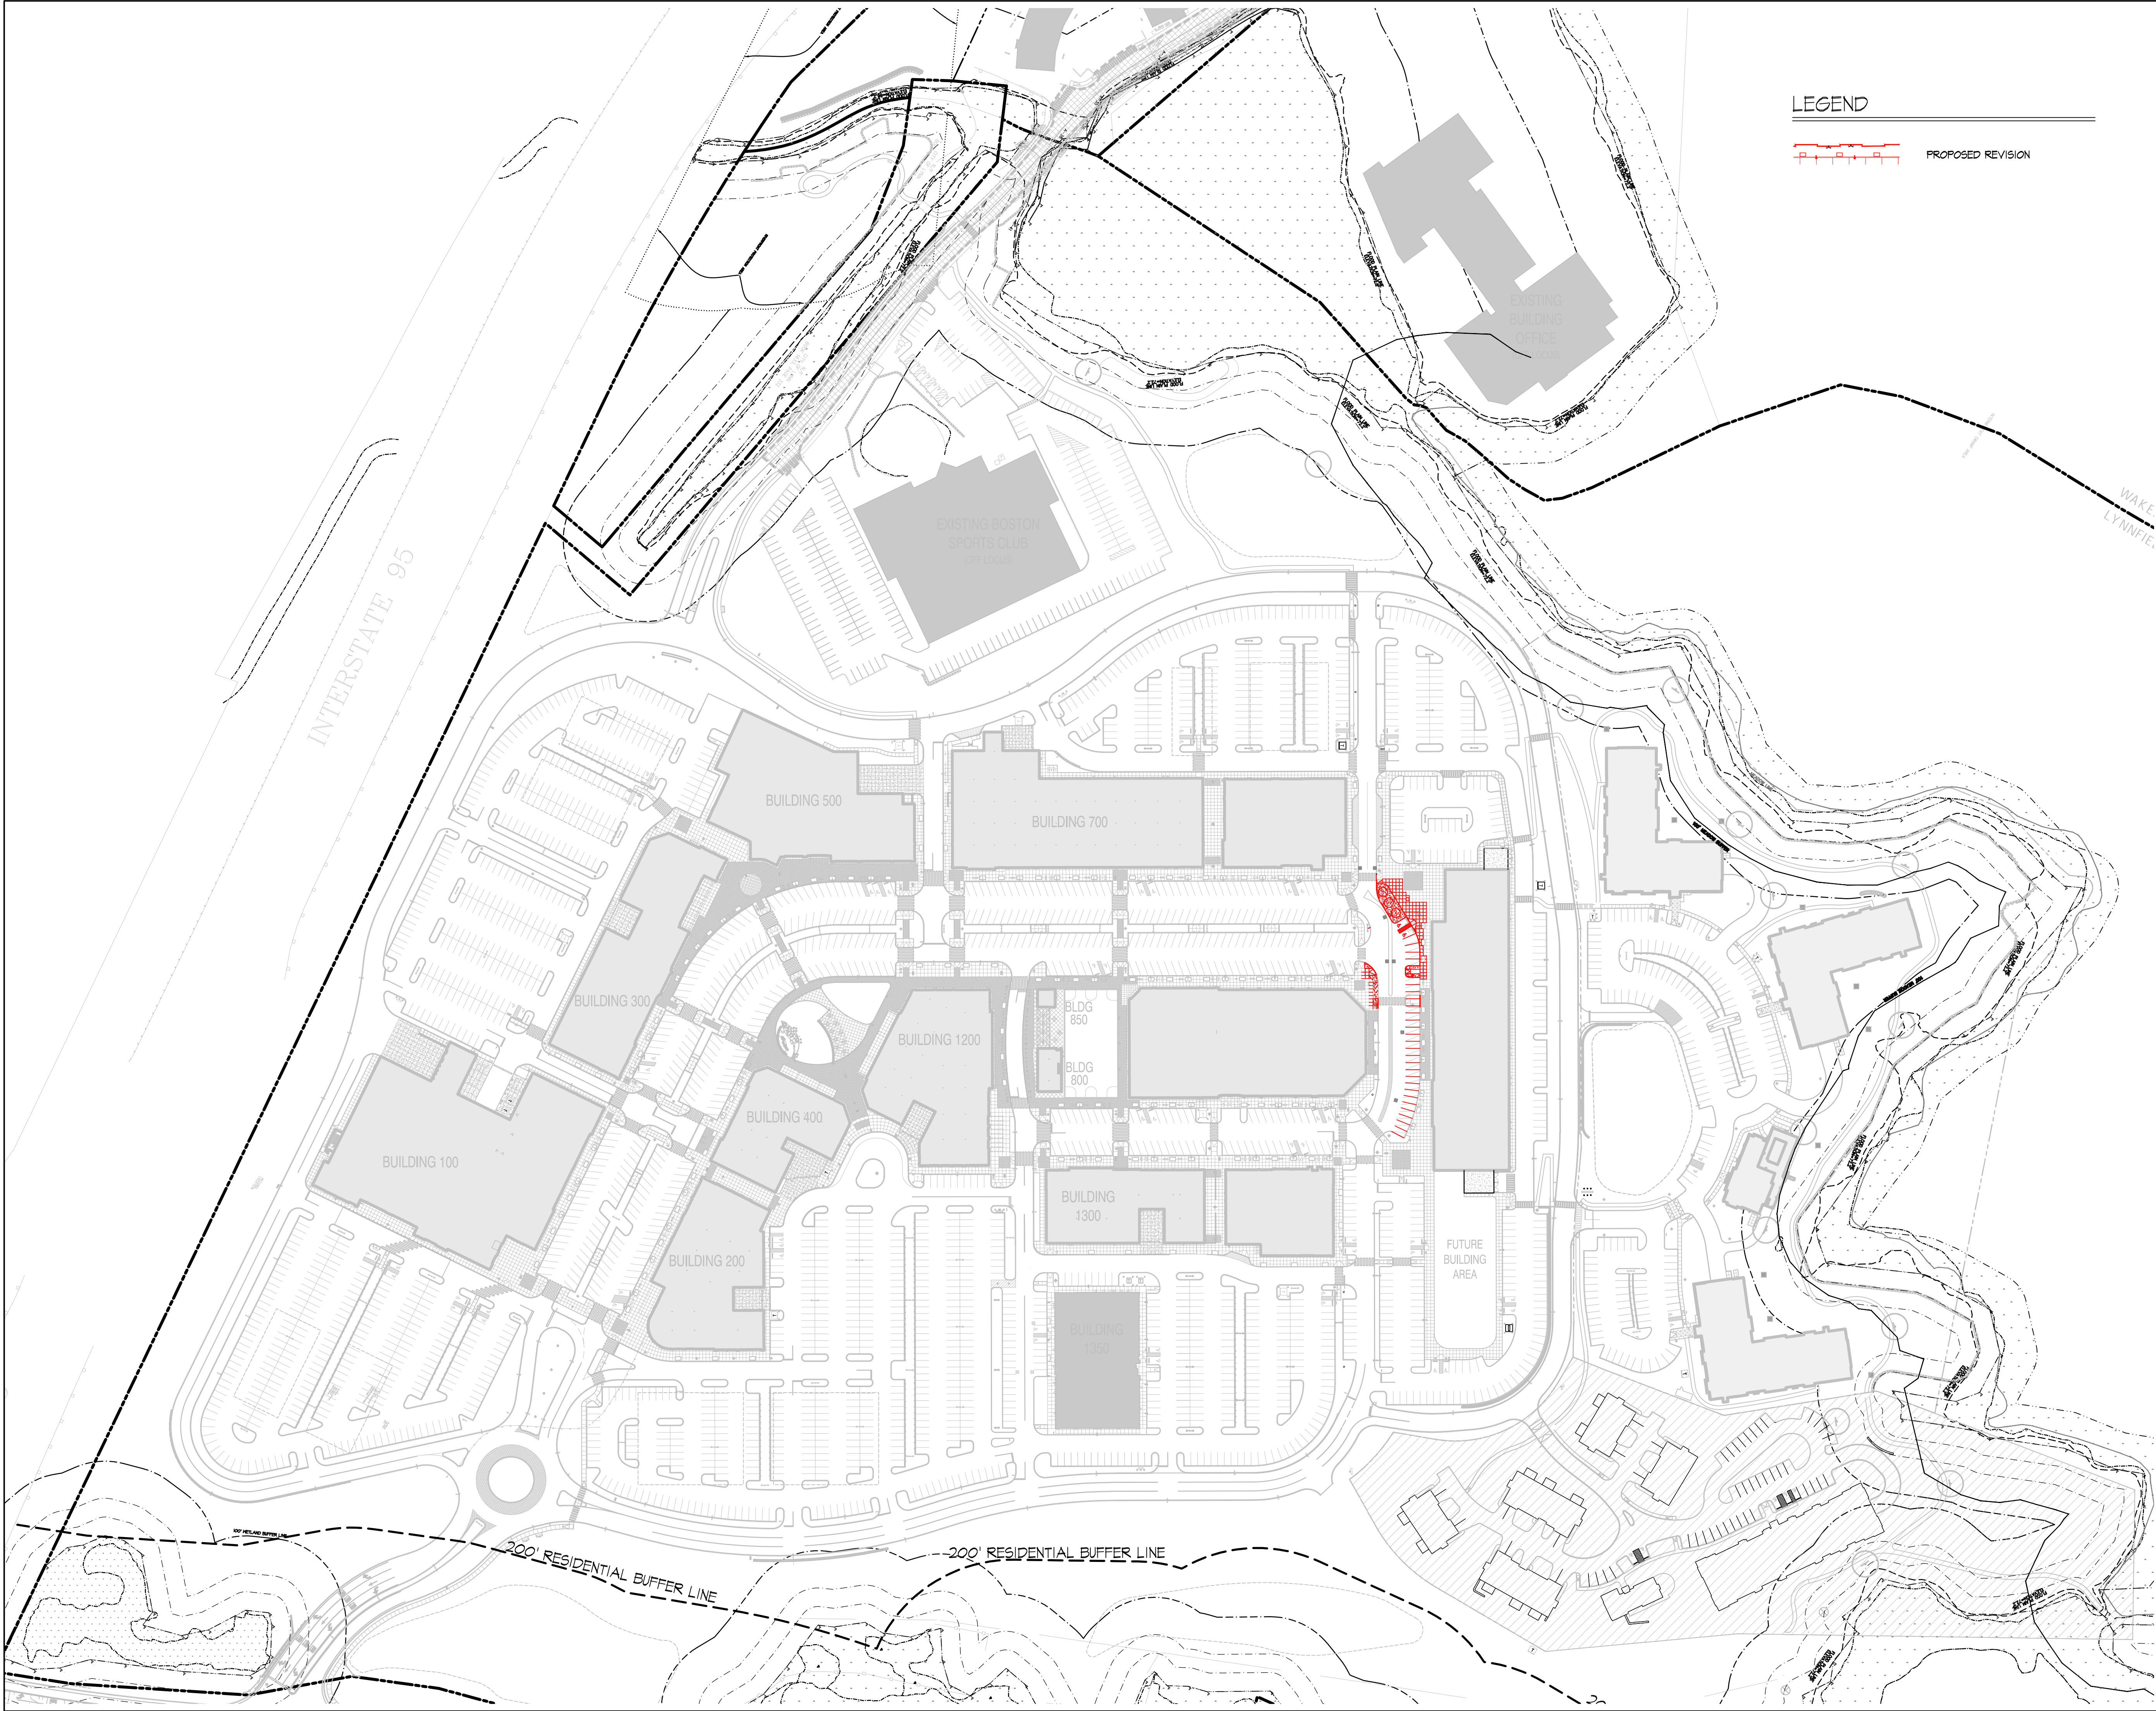
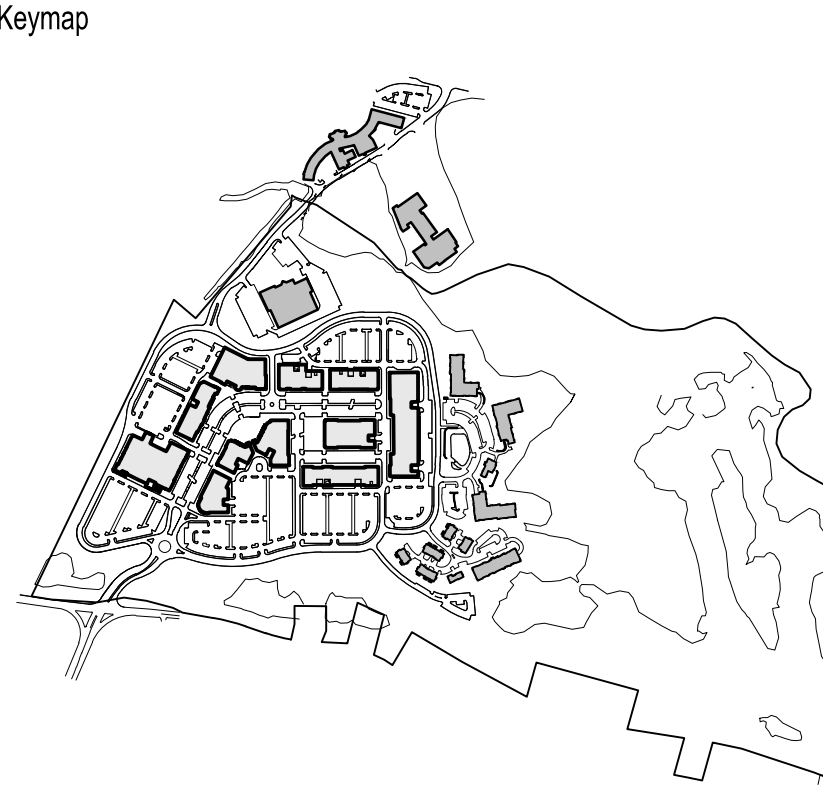


Wednesday, February 22, 2023 9:22:15 PM
\\US0297-PFSS01\Workgroup\2108\active\210801791\design\drawing\current\210801791-redlined-base-parking.dwg

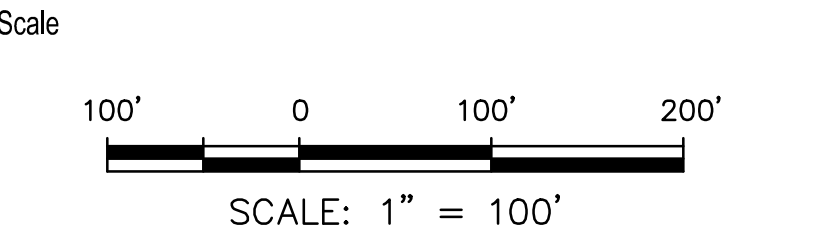


226 Causeway Street, 6th Floor
Boston, MA 02114
Tel. 617.523.8103
www.stantec.com

Copyright Reserved
The Contractor shall verify and be responsible for all dimensions. DO NOT scale the drawing - any errors or omissions shall be reported to Stantec without delay.
The Copyrights to all designs and drawings are the property of Stantec. Reproduction or use for any purpose other than that authorized by Stantec is forbidden.

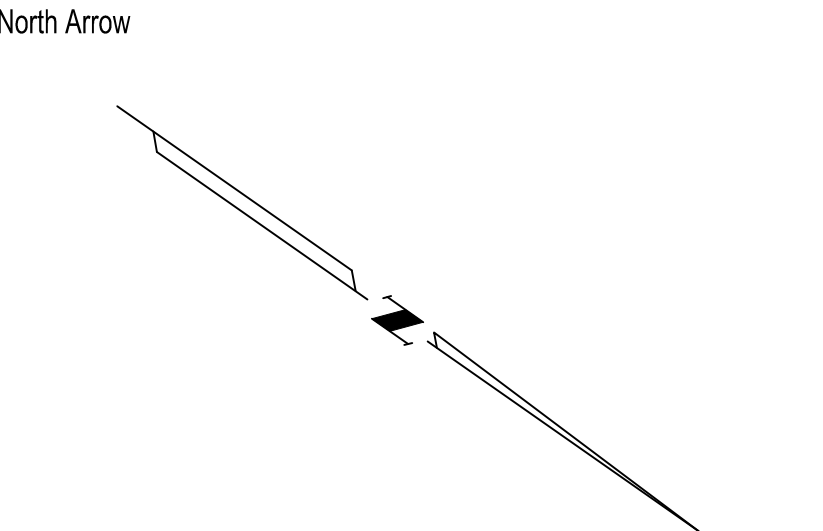

Various revisions	09.16.22
Various revisions	02.12.21
Various revisions	04.03.20
Various revisions	07.18.18
Various revisions	02.24.17
Various revisions	04.28.14
Various revisions	07.30.13
Various revisions	02.01.11
Various revisions	05.02.08
Response to Comments from Crowe	04.04.08
Planned Village Development District Application	01.18.08
Notice of Intent	01.10.08
Issued	MM.DD.YY

File Name: 210801791-redlined-base-parking.dwg
Dwn. Chkd. MM.DD.YY

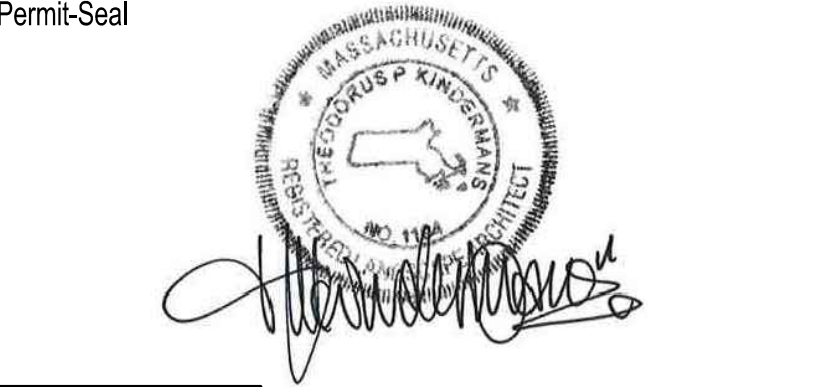

Applicant/Project
Market Street South LLC
c/o National Development
2310 Washington Street
Newton Lower Falls, MA 02462
MARKETSTREET LYNNFIELD
Lynnfield, MA

Title
REDLINED OVERALL LAYOUT AND
MATERIALS PLAN

Project No.
210800677
1" = 100'-0"

Drawing No.
LR-12.0