



SCHEDULE OF PIPE INVERTS	
LOCATION	INVERT
SEPTIC TANK INLET	74.12'
SEPTIC TANK OUTLET	73.85'
PUMP TANK INLET	73.80'
PUMP TANK OUTLET	76.76'
DISTR. BOX INLET	77.76'
DISTR. BOX OUTLET	77.59'
INFILTRATOR FIELD	77.45'
BOTTOM OF FIELD	76.95'

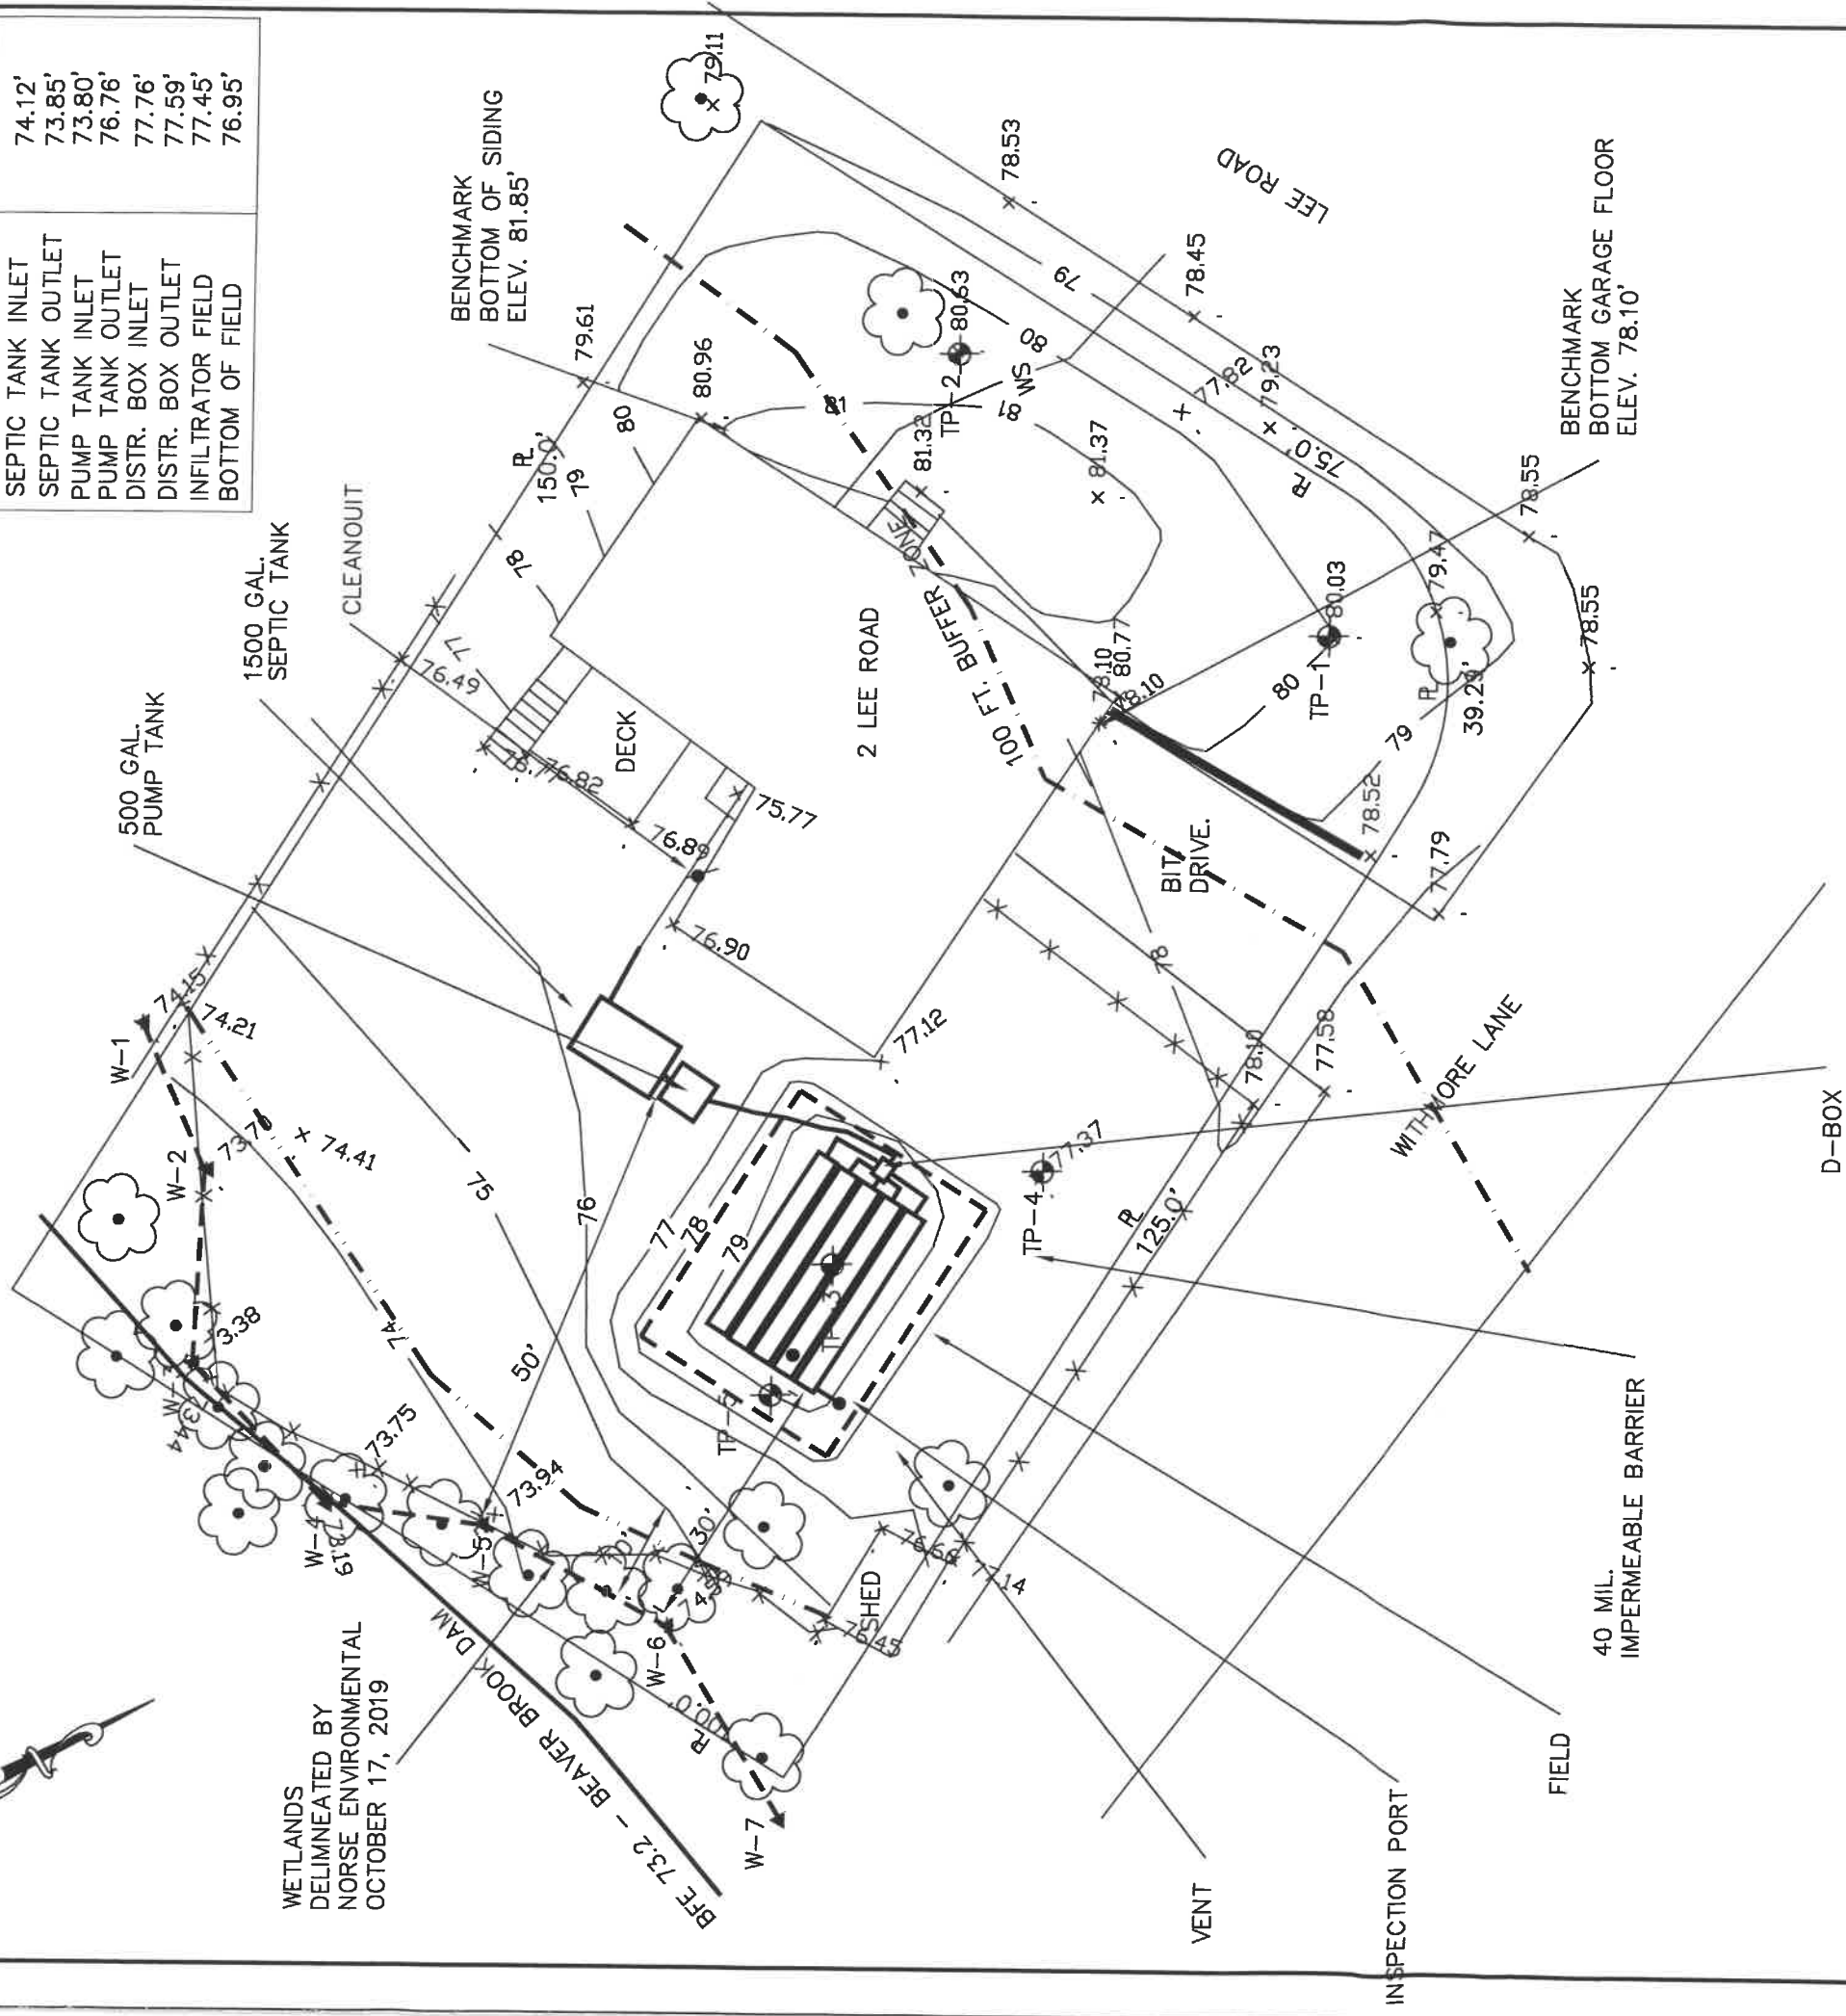

PLAN VIEW

SCALE : 1"=20'

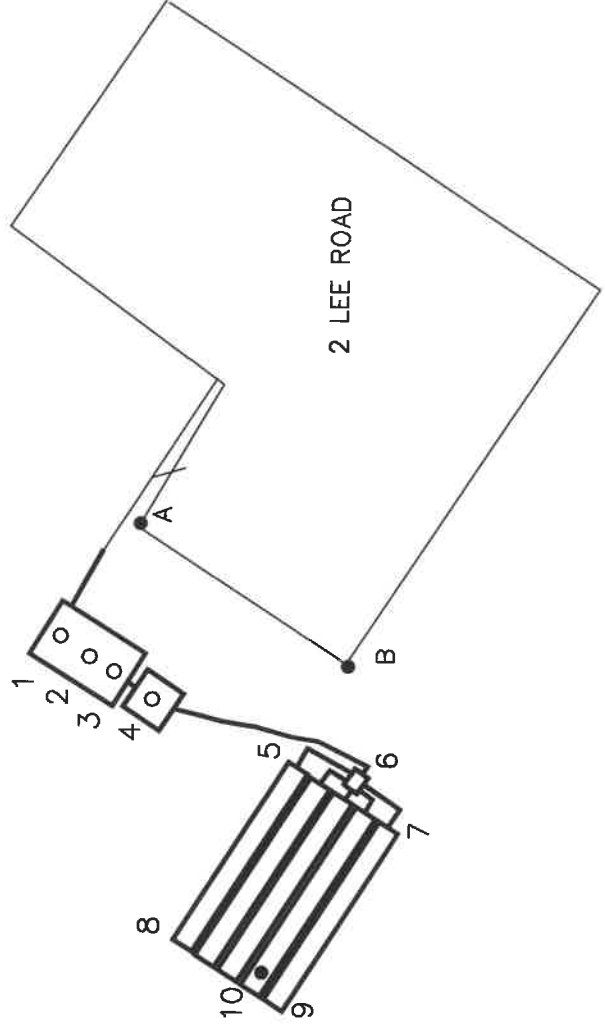

LOC.	PNT. A	PNT. B
1	14.0'	32.7'
2	14.1'	28.3'
3	14.7'	26.3'
4	17.6'	21.7'
5	30.0'	12.6'
6	35.6'	13.0'
7	43.1'	19.6'
8	44.0'	34.0'
9	54.4'	38.0'
10	50.0'	34.0'



Drawing No.		1 - 1	
Rev.	Date	Description	
1	6/30/20	AS-BUILT	
Proj No. 13014		Scale 1"=20'	
Deen. By: JMK		Dm. By: JMK	
Chkd. By: DMC		Appd. By: IMK	

JAMES M. KAVANAUGH, P.E.

14 Shady Hill Drive
N. Reading, MA 01864 Tel. (978) 664-2925

SEPTIC SYSTEM

CLIENT: Edward Sylvester