

As Built Plan To
Accompany Request For
Certificate of Compliance


in
LYNNFIELD, MASS.

Hayes Engineering, Inc.
Civil Engineers & Land Surveyors
603 Salem Street
Wakefield, MA 01880

Telephone: 781.246.2800
Facsimile: 781.246.7596
www.hayeseng.com

Hayes

Scale: 1" = 20'

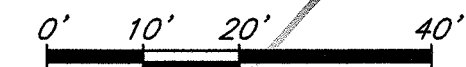

October 12, 2022

#244 Main Street

