



LEGEND

 PROPOSED REVISION


North Arrow

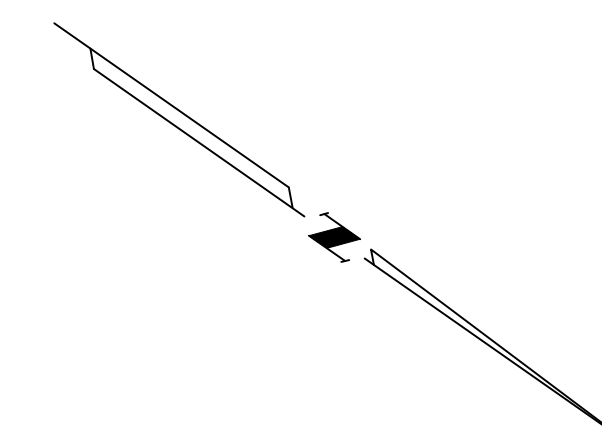

Scale

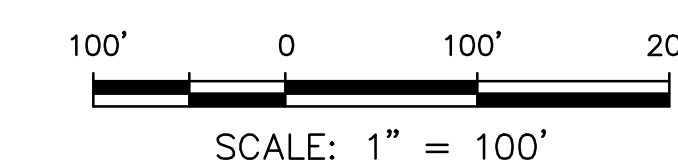

Keymap

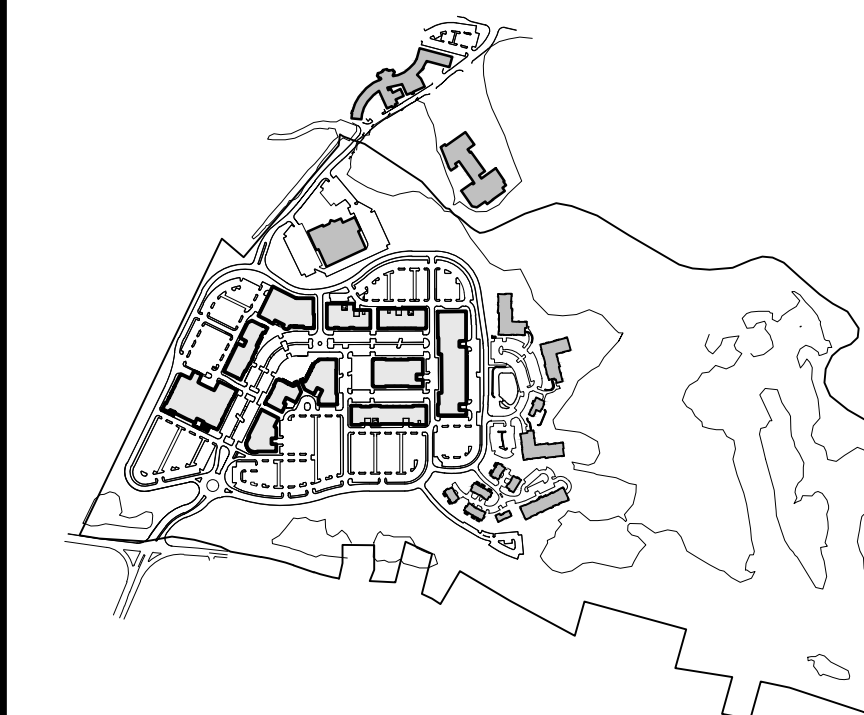

Various revisions	02.12.21
Various revisions	04.03.20
Various revisions	07.18.18
Various revisions	02.24.17
Various revisions	04.28.14
Various revisions	07.30.13
Various revisions	02.01.11
Various revisions	05.02.08
Response to Comments from Crowe	04.04.08
Planned Village Development District Application	01.18.08
Notice of Intent	01.10.08
Issued	MM.DD.YY

File Name: 210801791-redlined-base-parking.dwg Dwn. Chkd. MM.DD.YY

Permit-Seal



Applicant/Project

Market Street South LLC
 c/o National Development
 2310 Washington Street
 Newton Lower Falls, MA 02462

MARKETSTREET LYNNFIELD
 Lynnfield, MA

Title

REDLINED OVERALL LAYOUT AND
 MATERIALS PLAN

Project No.
 210800677

1" = 100'-0"

Drawing No.

LR-12.0

