


PLAN OF LAND  
IN  
LYNNFIELD, MASSACHUSETTS  
SHOWING  
1466 MAIN STREET  
DATE: 03-13-23 SCALE: 1"=50'

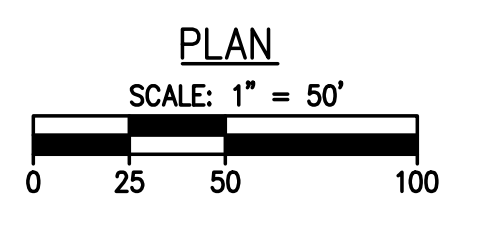

The  
**Morin-Cameron**  
GROUP, INC.

CIVIL ENGINEERS | ENVIRONMENTAL CONSULTANTS  
LAND SURVEYORS | LAND USE PLANNERS  
66 ELM STREET, DANVERS, MASSACHUSETTS 01923  
P: 978-777-8586, W: WWW.MORINCAMERON.COM