

UNIT #27
F.F. ELEV=142.13
G.F. ELEV=140.41

UNIT #33
F.F. ELEV=148.16
G.F. ELEV=145.44

UNIT #34
F.F. ELEV=146.47
G.F. ELEV=145.09

UNIT #35
F.F. ELEV=146.44
G.F. ELEV=144.59

UNIT #26
F.F. ELEV=142.14
G.F. ELEV=139.65

UNIT #25
F.F. ELEV=142.13
G.F. ELEV=139.22


LIMIT OF 25'
NO DISTURB ZONE

AS BUILT CONTROL STRUCTURE
R=130.51
18" RCP INV. IN = 127.21
3" ORIFICE @ EL. 127.21
(3) 8" ORIFICE @ EL. 128.22
12" RCP INV. OUT = 127.36
TOP OF BAFFLE @ EL. 129.1

AS BUILT
12" RCP
INV.=127.52

**"WINDSOR ESTATES CONDOMINIUM"
AS BUILT PLAN
IN
LYNNFIELD, MA**

SCALE: 1" = 10'
DATE: FEBRUARY 19, 2020
"SHOWING RES03"

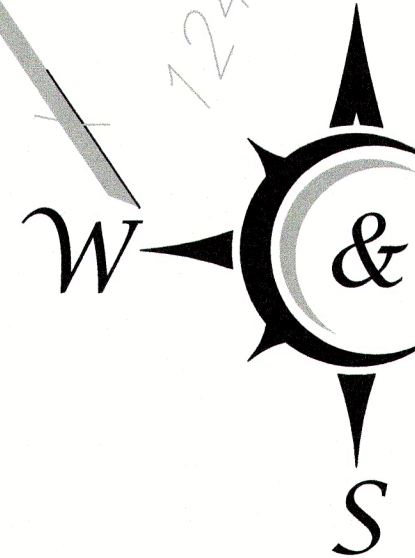

**WILLIAMS
&
SPARGES**
ENGINEERS | PLANNERS | SURVEYORS
189 NORTH MAIN STREET
SUITE 101
MIDDLETON, MA 01949
PHONE: (978) 539-8088
FAX: (978) 539-8200
WWW.WSENGINEERS.COM